
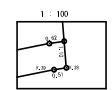
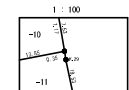
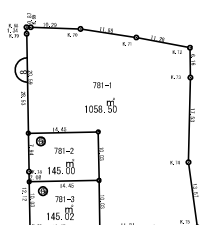
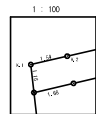


相模原市相原4 丁目画地出来形確認測量原図 縮尺 1 : 5 0 0

平成十四年五月作製

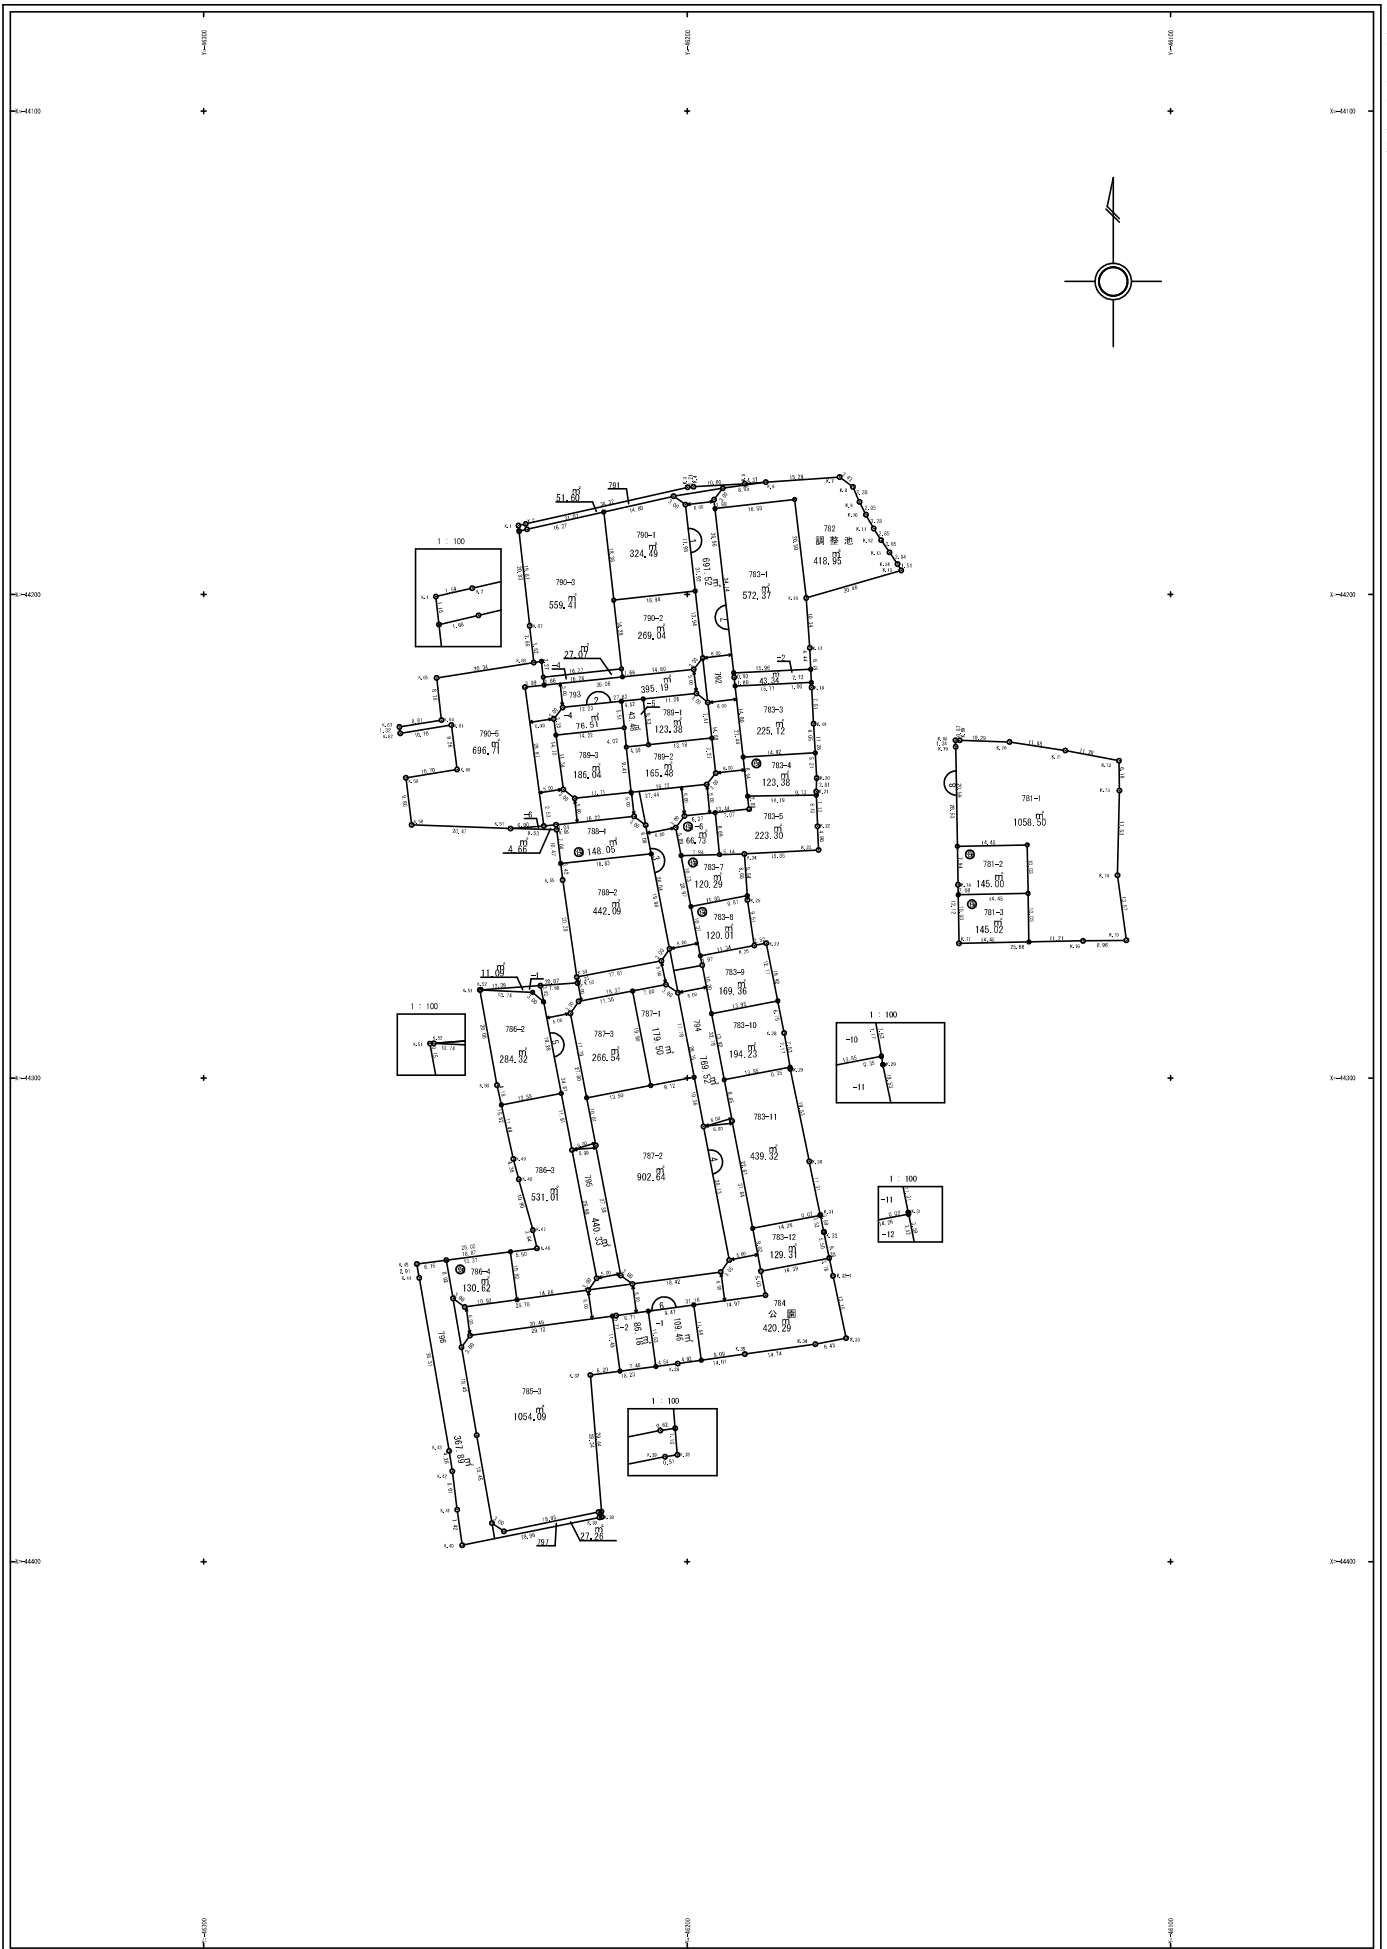

44100

44300

44500

44100

44300

44500

44800

34400

34600

34800

35000